

P-2 Executive Work Wall

Halcon Proximus Multitasking Executive Work Wall

~~108" wide x 96" high x 25" deep~~ *120" wide x 94" high x 25" deep*

Dark stained Wenge wood





P-2 Executive Work Wall


Halcon Proximus Multitasking Executive Work Wall

~~108" wide x 96" high x 25" deep~~ *120" wide x 84" high x 25" deep*

Dark stained Wenge wood




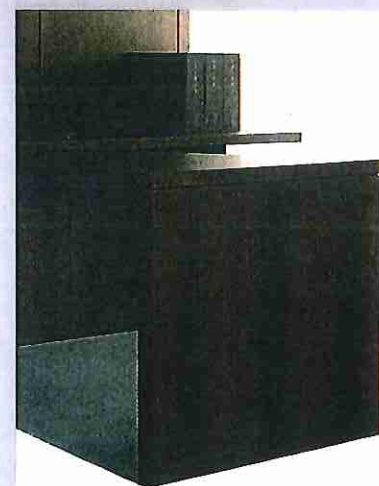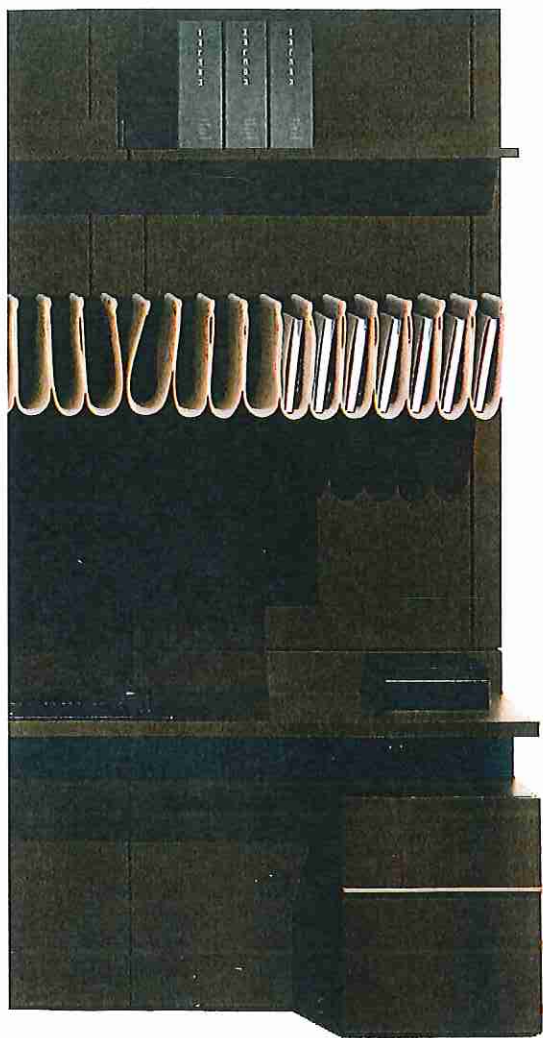

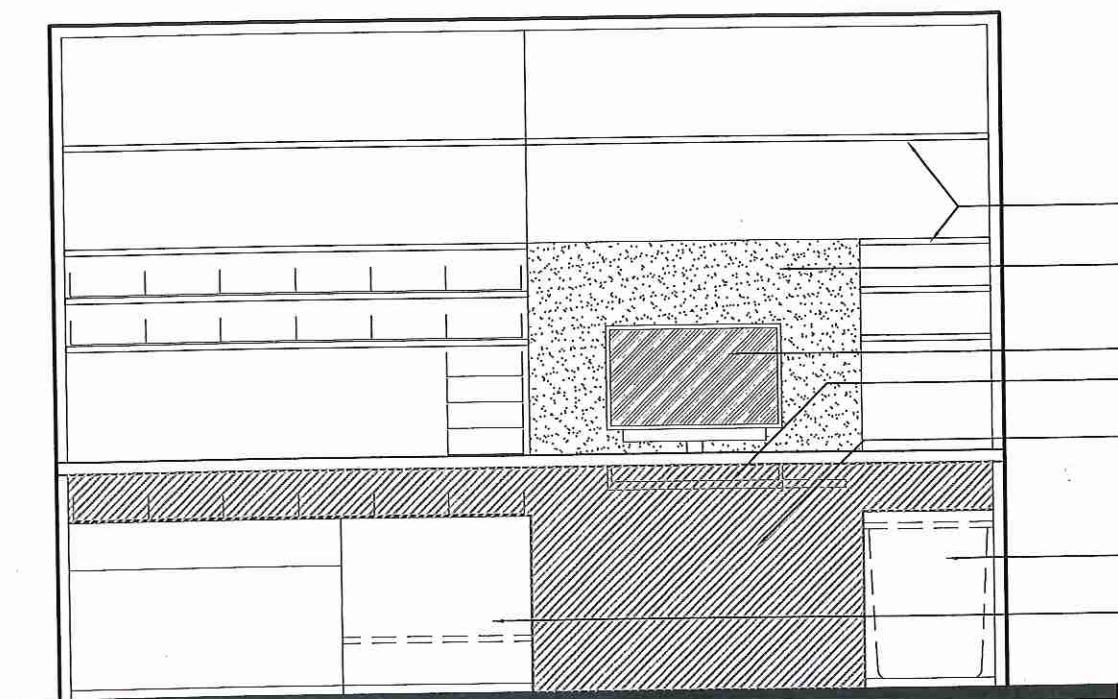

Work Wall Open

- SLIDING DOOR PANEL, ONE OF TWO
- OPEN, CANTILEVERED WOOD SHELVES
- TACKBOARD
- FLAT SCREEN COMPUTER
KEYBOARD TRAY BELOW
- OPEN KNEE SPACE BELOW COUNTER
- PULL-OUT TRASH BIN
- PULL-OUT PRINTER DRAWER WITH
PAPER STORAGE BELOW

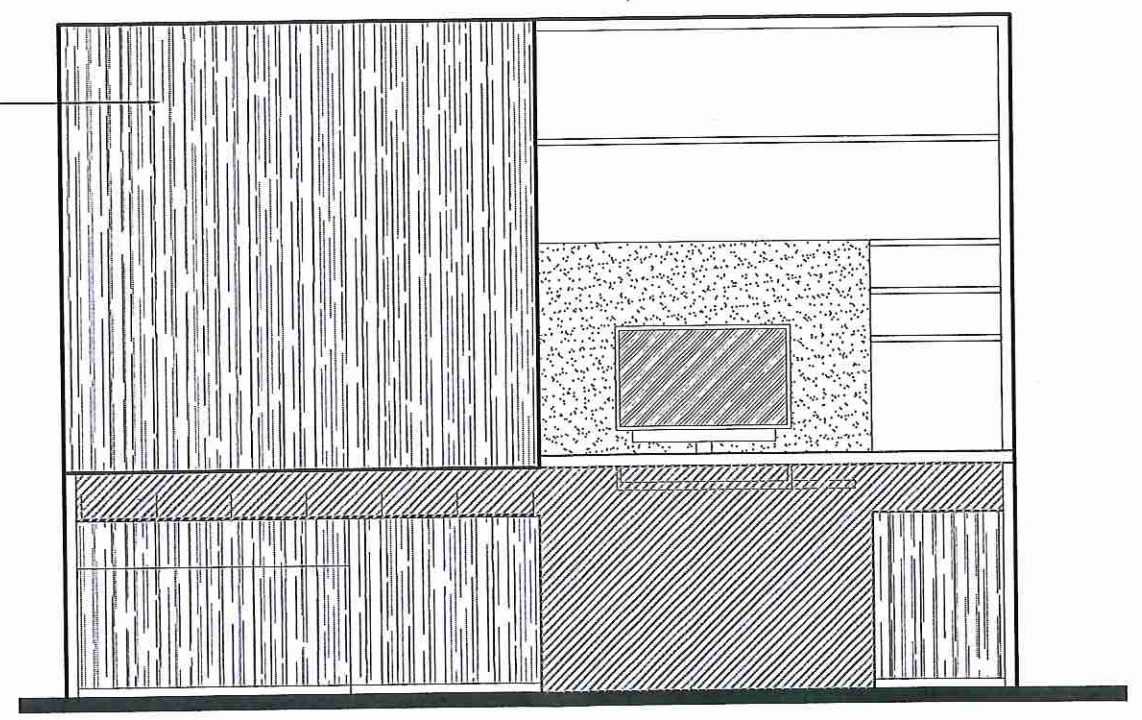

Work Wall Half Closed



AD 111 - President's Office - Work Wall Elevations

SCALE: AS SHOWN ON BAR SCALE

CAMPUS: 01
LAKE WORTH

DATE 8-15-2016

PALM BEACH STATE COLLEGE
FACILITIES PLANNING & CONSTRUCTION
4200 CONGRESS AVE., LAKE WORTH, FL 33461

FURN-F4

2ND FLOOR

E:\01-0111-FFP-2014.dwg